


Terrace Plan

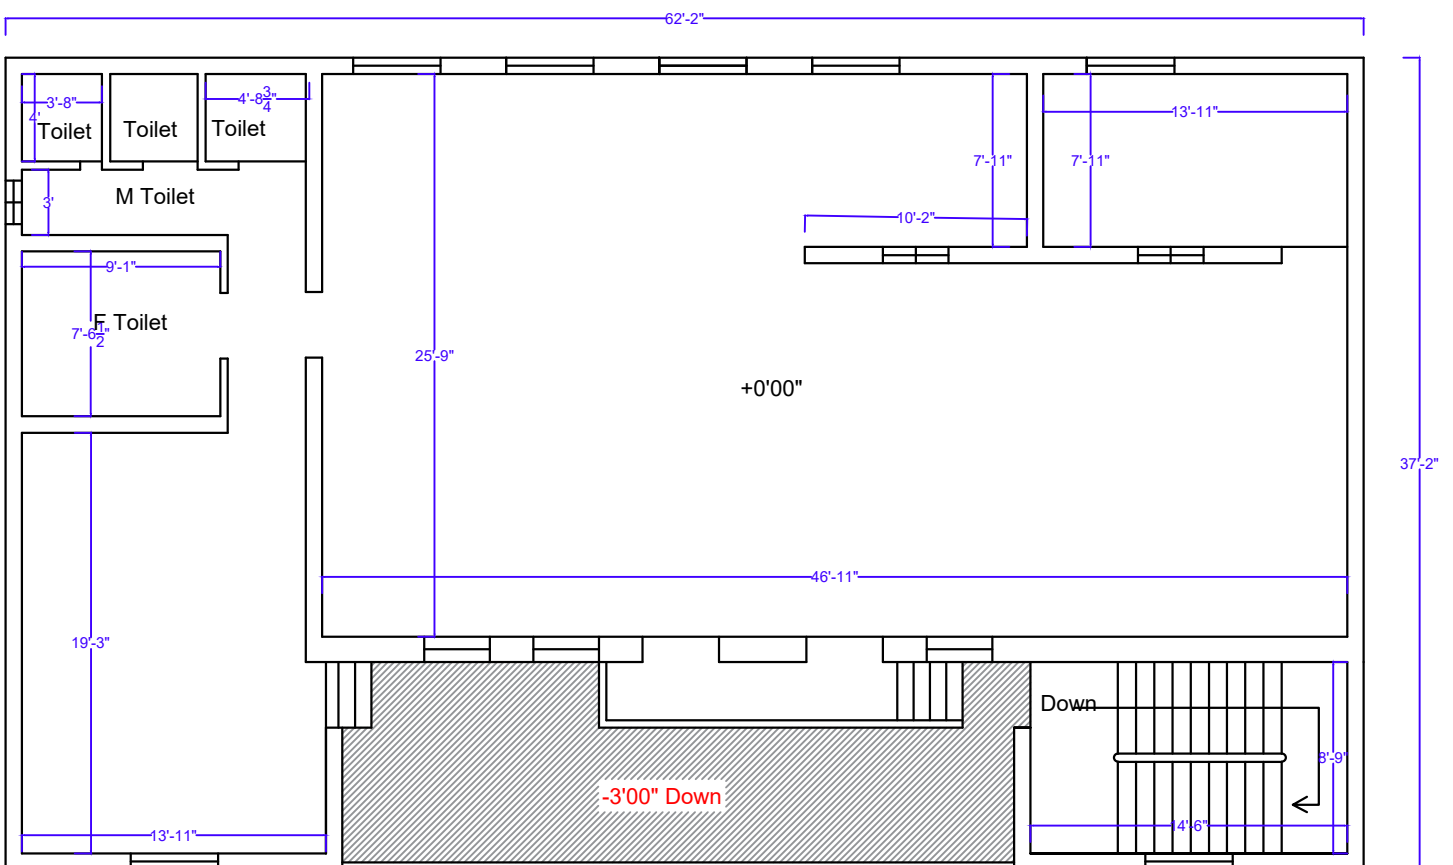

First Floor Plan