
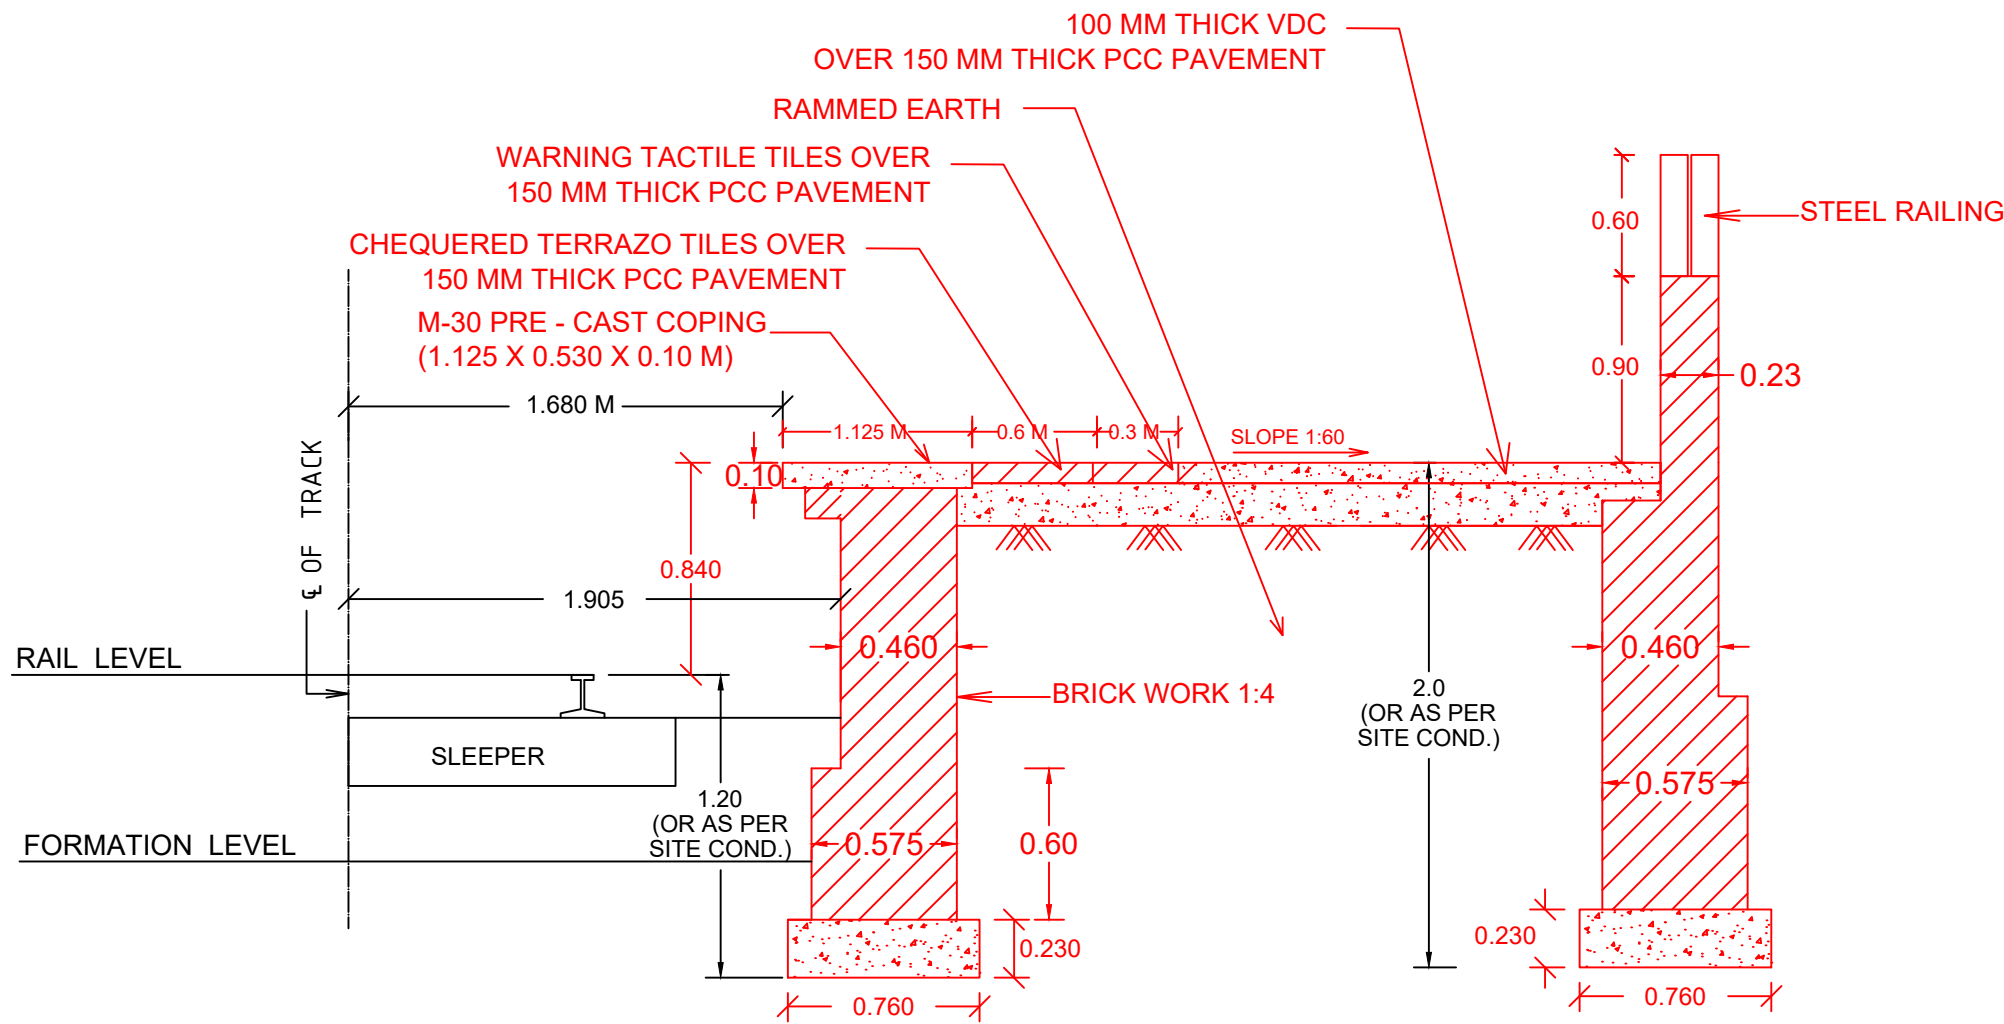


- NOTES:-**
- EXISTING WORK SHOWN IN BLACK.
 - PROPOSED WORK SHOWN IN RED.
 - WORK TO BE DISMANTLED SHOWN IN GREEN.
 - ALL DIMENSIONS ARE IN METRE EXCEPT OTHERWISE WHERE STATED.
 - FOR PRE-CAST COPING REFER N.R. TYPE PLAN NO. P-34 (SHEET NO. 1 & 2)
 - ALL WORK SHALL BE DONE AS PER RLY. STANDARD SPECIFICATIONS.
 - PROPER BED THICKNESS SHOULD BE PROVIDED FOR CHEQUERED TILES
 - TO ACHIEVE REQUIRED LEVEL OF PLATFORM.
 - PRIOR INFORMATION WILL BE GIVEN TO S&T DEPARTMENT BEFORE STARTING THE WORK.
 - AT MAST SHIFTING/ RELOCATION WILL BE REQUIRED.
 - STANDARD RAMPS AND OTHERS MINIMUM ESSENTIAL AMENITIES AS PER DIVYANGJAN GUIDELINES NO.2019/STN. DEV.-1/03/06/POLICY (PNDC) DATED 28.11.2023 TO BE ENSURED.
 - PROVISION OF PLATFORM UTILITY DUCTS SHALL BE DONE AS PER RB LETTER NO. 2022/GS/STN.DEV.-1/08/70 DATED 25.07.2025.
 - TACTILE PATH FOR DIVYANGJAN MOVEMENT SHOWN BY.
 - EXCAVATION WORK MUST BE DONE MANUALLY IN THE VICINITY OF S&T CABLES/GEARS IN THE PRESENCE OF S&T OPEN LINE STAFF
 - SAFETY OF ELECTRICAL CABLES DURING EXECUTION OF WORK AT SITE WILL BE ENSURED AND PRIOR INFORMATION TO SSE/ELECT/LGH WILL BE GIVEN

WORK SANCTIONED YR 2025-26
PROJECT ID: 09.02.53.25.3.00.021

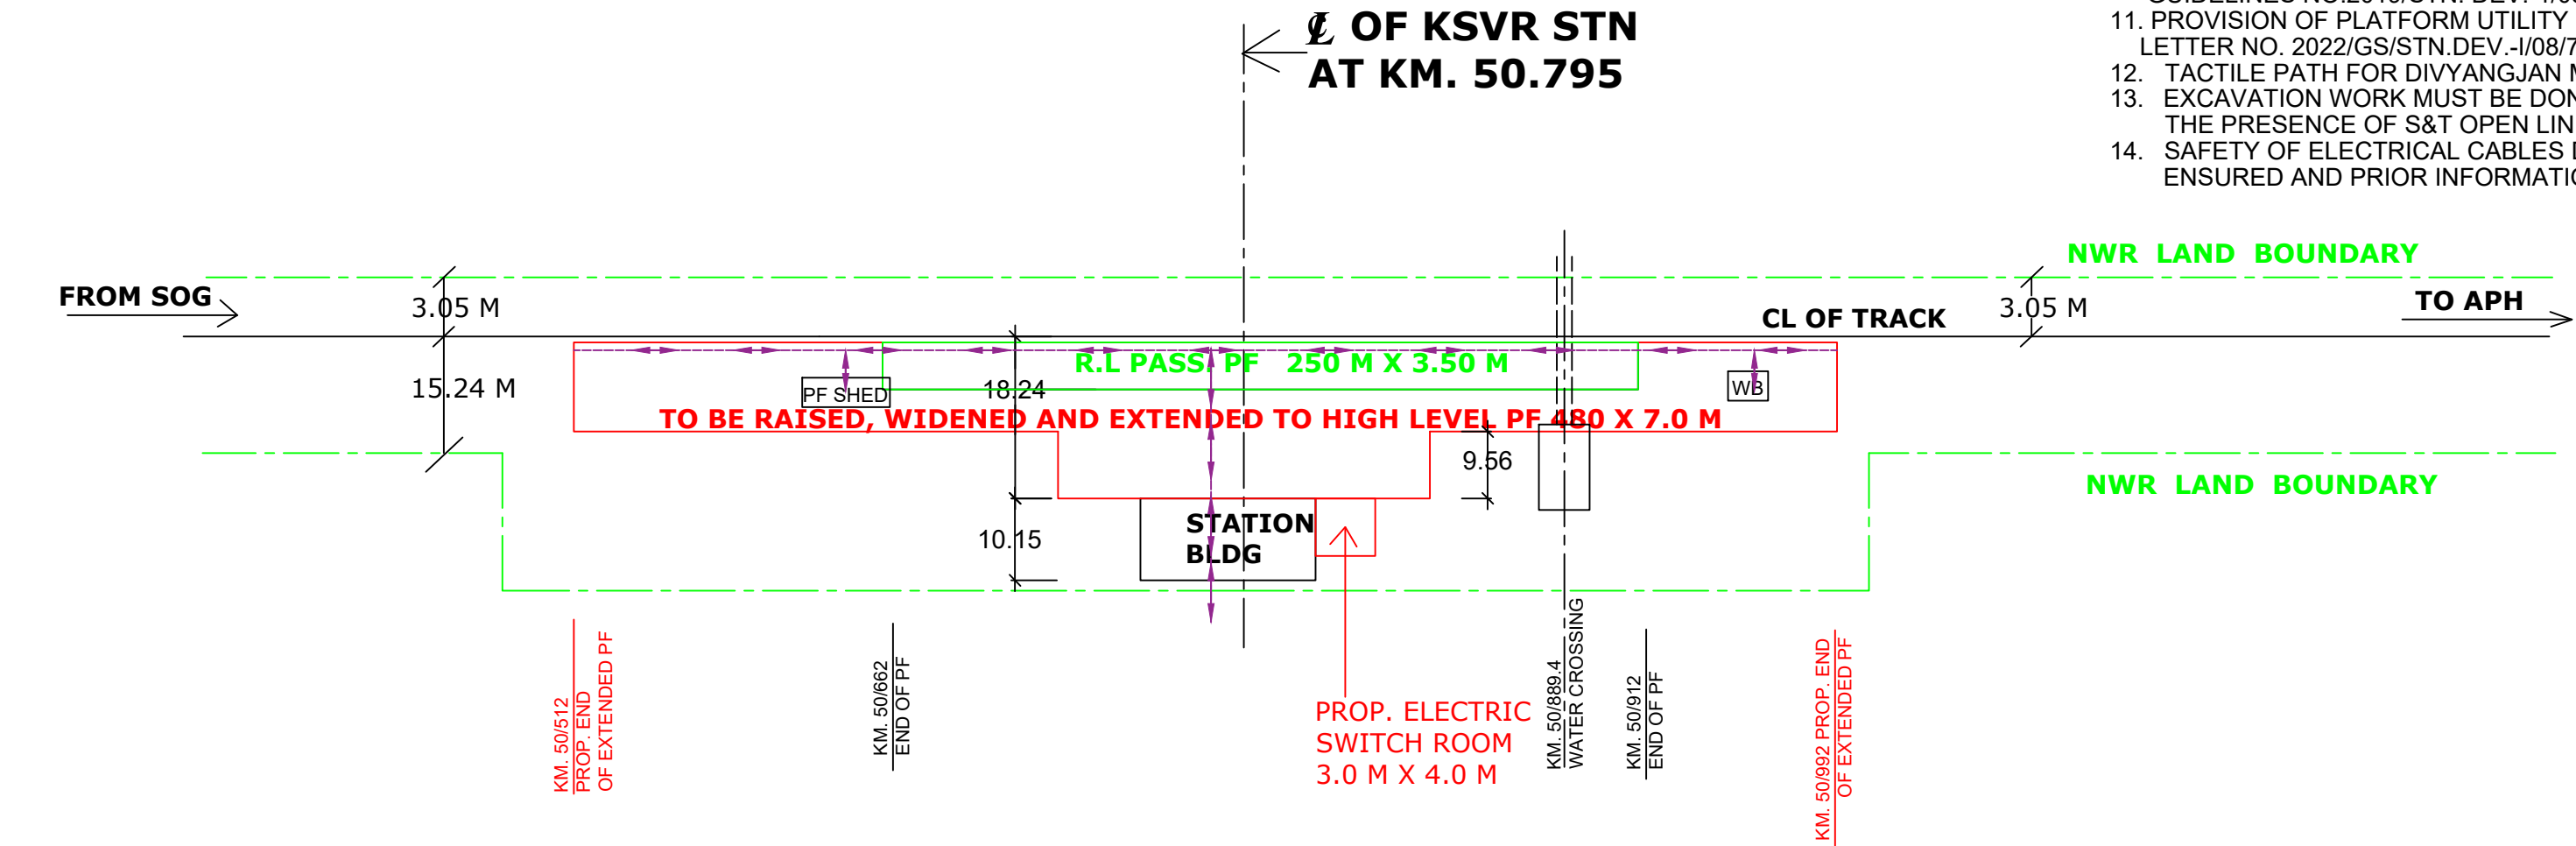

TYPICAL SECTION OF PF

PROPOSAL CHECKED AT SITE AND FOUND FEASIBLE

DRAWN BY- MAYANK RAWAT

sd- CMI/ sd- SSE/TRD/ sd- SSE/SIG/ sd- SSE/TELE TI/ sd- SSE/ELECT./ sd- SSE/PWAY/SOG sd- SSE/W/SOG sd- ADEN/SOG

Signature block		
DRM-BKN		
SR-DEN-CO-BKN		
SRDOM-BKN		
SR-DCM-BKN		
SR-DEE-G-BKN		
SR-DEE-TRD-BKN		
SR-DSTE-BKN		
SR-DEN-W-BKN		
DIVL. OFFICER'S SIGN.		
N.W.R. BIKANER DIVISION		SOG - APH SECTION
KESHAV NAGAR HALT PROPOSED RAISING AND EXTENSION OF RL PASS. PLATFORM TO HIGH LEVEL AT KSVR STATION (KM 50/795) ON SOG - APH SECTION.		
SCALE:- NOT TO SCALE		
DIVL. CASE NO.-		CANCEL PLAN NO.
DIVL. PLAN NO.-		
N.W.R. BKN DIVL. PLAN NO.- SR. DEN - 120/ 2026		